

LONGITUDINAL SECTION A - A' ALONG CENTRELINE OF EXISTING ACCESS ROAD

HORIZONTAL SCALE 1:1000
VERTICAL SCALE 1:500

NOTES

1. FIGURED DIMENSIONS ONLY TO BE TAKEN FROM THIS DRAWING
2. ALL DRAWINGS TO BE CHECKED BY THE CONTRACTOR ON SITE
3. ENGINEER TO BE INFORMED BY THE CONTRACTOR OF ANY DISCREPANCIES BEFORE ANY WORK COMMENCES
4. ALL LEVELS SHOWN RELATE TO ORDNANCE SURVEY DATUM AT MALIN HEAD

| Rev | Date | Description | By | Chkd. |
|-----|----------|--------------------------|----|-------|
| E | 01-02-09 | ISSUED FOR RE-SUBMISSION | VB | MC |
| D | 10-11-08 | ISSUED FOR SUBMISSION | VB | MN |

Applicant: Shell E&P Ireland Limited
Corrib House, 52 Leeson Street Lower,
Dublin 2, Republic of Ireland.

Operator: BORD NA MÓNA

Project: CORRIB ONSHORE PIPELINE DEVELOPMENT

Aspect: SRAHMORE PEAT DEPOSITION SITE

Title: ACCESS ROAD LONGITUDINAL SECTION (As Built)

Scale @ A 1: AS SHOWN

Prepared by: V. Bonney
Checked: M. Nolan
Date: Feb 2009



Project Director: S. Finlay

TOBIN
Patrick J. Tobin & Co. Ltd.

TOBIN Consulting Engineers,
Block 10-4, Blanchardstown Corporate Park,
Dublin 15, Ireland.
tel: +353-(0)1-8030406
fax: +353-(0)1-8030409
e-mail: dublin@tobin.ie
www.tobin.ie

Drawing No.: 4903-2032

Revision: E

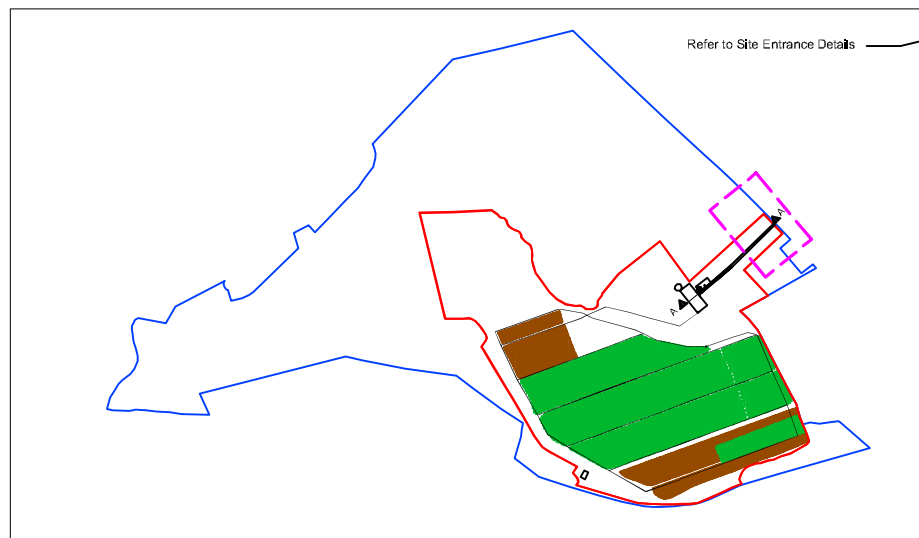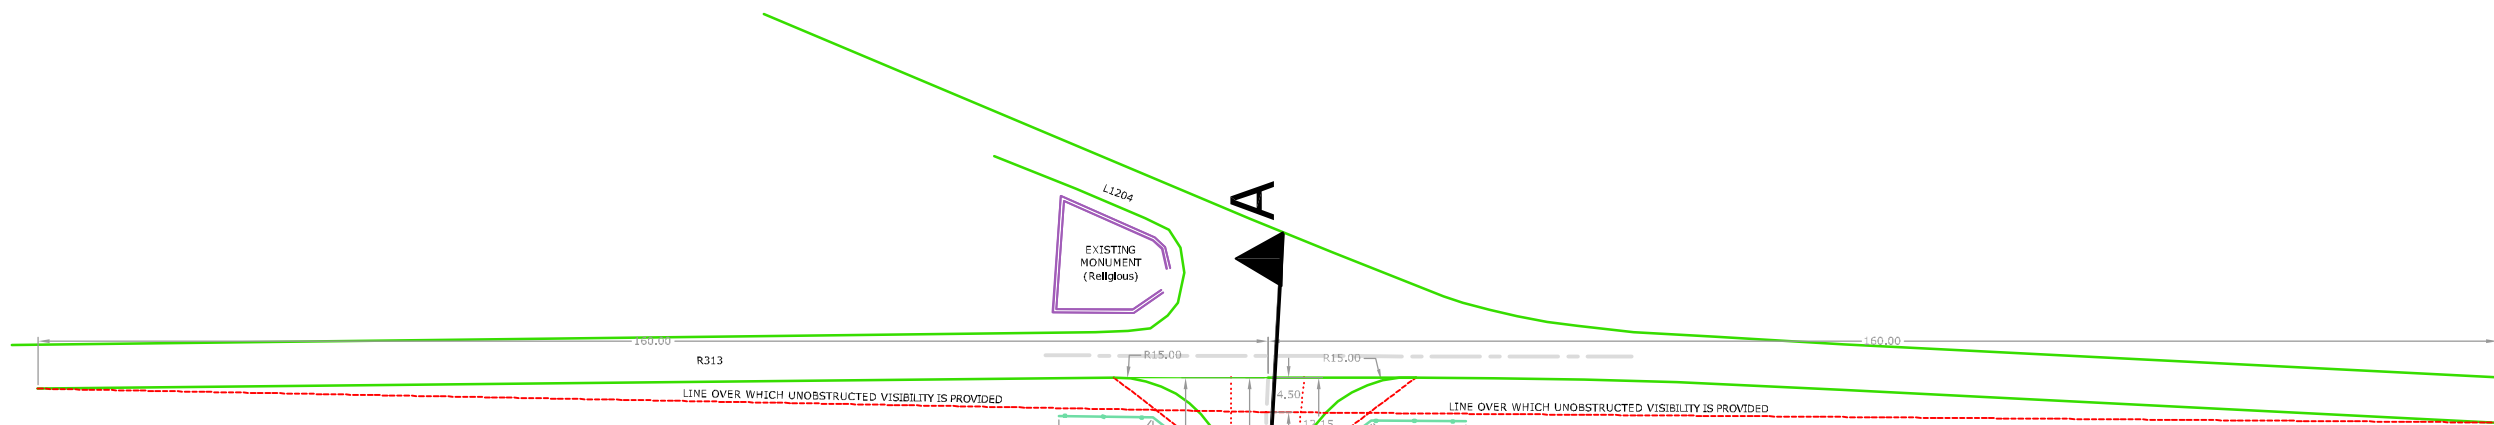

KEY PLAN
N.T.S.

SITE ENTRANCE DETAILS

SCALE 1:500