




TYPICAL CROSS SECTION THROUGH ACCESS ROAD
SCALE 1:50

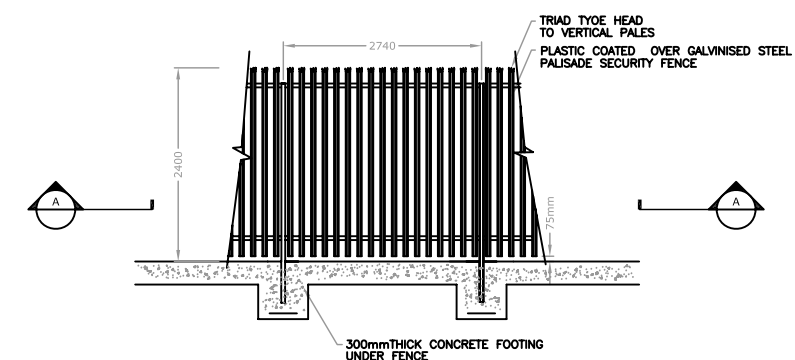


SECTIONAL ELEVATION ON PALISADE FENCING
SCALE 1:50

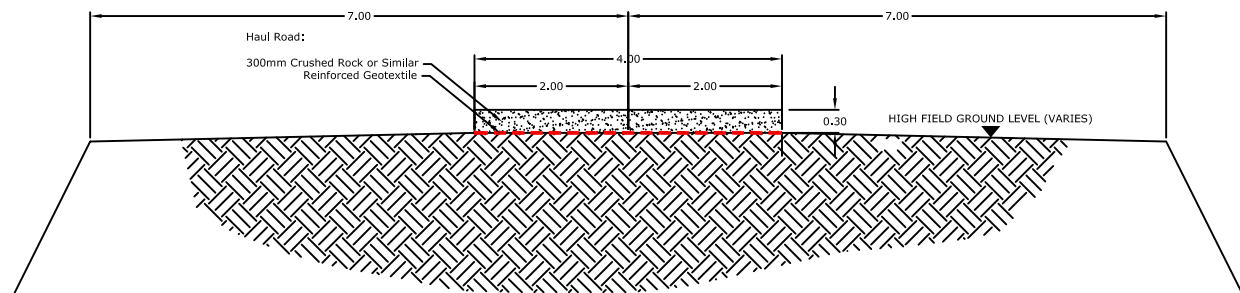





TYPICAL CROSS SECTION THROUGH HAUL ROAD
SCALE 1:50

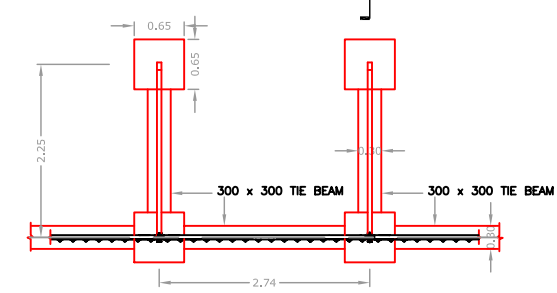


PLAN OF PAD AND FOUNDATION DETAILS
SCALE 1:50

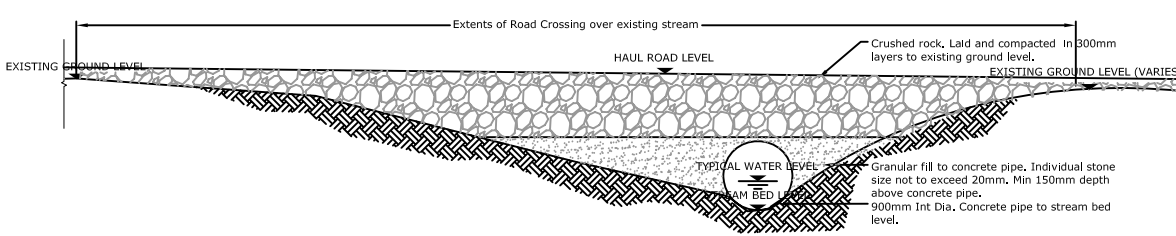

CROSS SECTION
SCALE 1:100

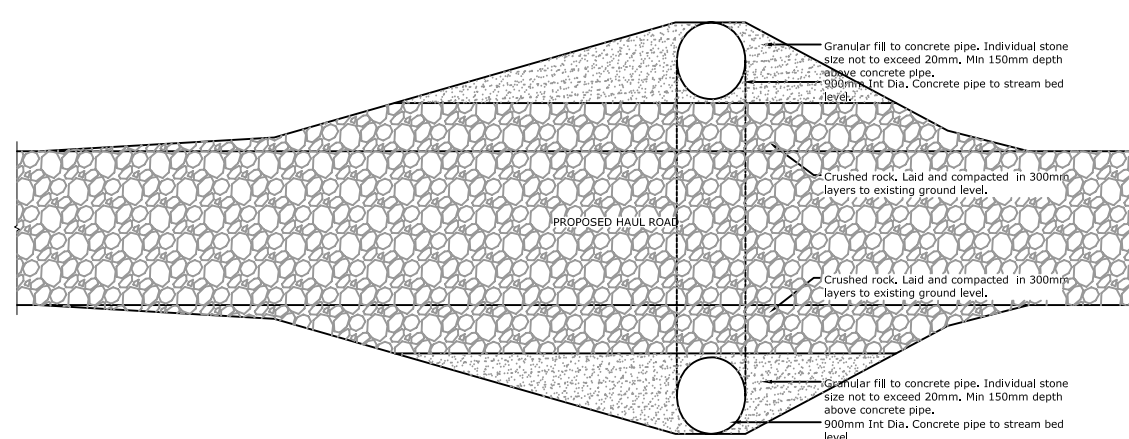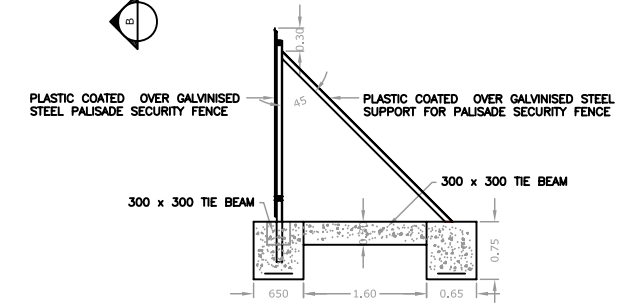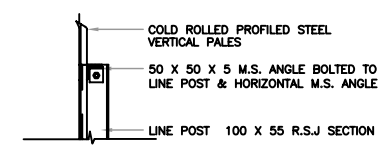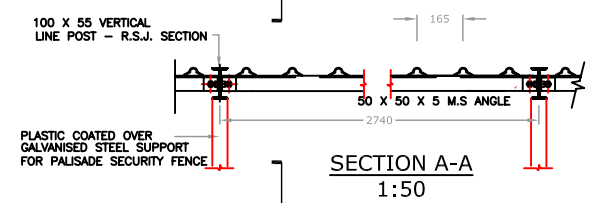

PLAN
SCALE 1:100

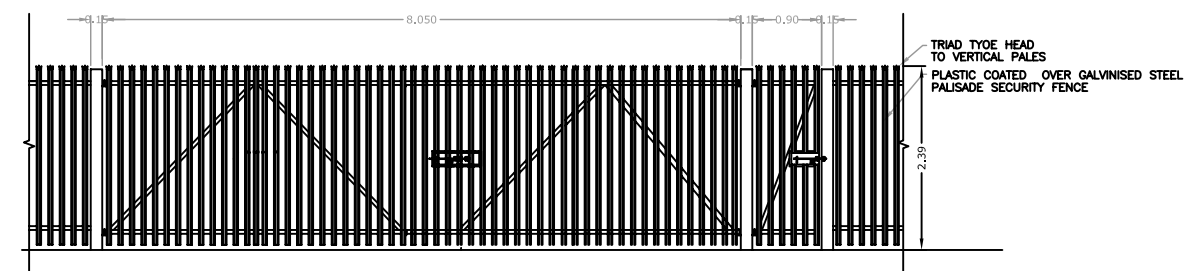

TYPICAL STREAM CROSSING
SCALE 1:100

- NOTES
1. FIGURED DIMENSIONS ONLY TO BE TAKEN FROM THIS DRAWING
 2. ALL DRAWINGS TO BE CHECKED BY THE CONTRACTOR ON SITE
 3. ENGINEER TO BE INFORMED BY THE CONTRACTOR OF ANY DISCREPANCIES BEFORE ANY WORK COMMENCES
 4. ALL LEVELS SHOWN RELATE TO ORDNANCE SURVEY DATUM AT MALIN HEAD

Rev	Date	Description	By	Chkd.
F	07-05-10	ISSUED FOR RE-SUBMISSION	MN	ST
E	01-02-09	ISSUED FOR RE-SUBMISSION	VB	MC
D	10-11-08	ISSUED FOR SUBMISSION	VB	MN

Applicant: Shell E&P Ireland Limited
 Corrib House, 52 Leeson Street Lower,
 Dublin 2, Republic of Ireland.

Operator: BORD NA MÓNA

Project: CORRIB ONSHORE PIPELINE DEVELOPMENT

Aspect: SRAHMORE PEAT DEPOSITION SITE

Title: ROAD CONSTRUCTION AND FENCING DETAILS ONTO R313 (As Built)

Scale @ A1: AS SHOWN

Prepared by: V. Bonney
 Checked: M. Nolan
 Date: March 2010

Project Director: S. Finlay

TOBIN
 Patrick J. Tobin & Co. Ltd.
 TOBIN Consulting Engineers,
 Block 10-4, Blanchardstown Corporate Park,
 Dublin 15, Ireland.
 tel: +353-(0)1-8030406
 fax: +353-(0)1-8030409
 e-mail: dublin@tobin.ie
 www.tobin.ie

Revised: F

Drawing No.: 4903-2031